

Type 1 Facility Closeout Report

Section A. Facility Data

Facility No.	B126
Facility Descriptor:	Source Calibration Facility
Project:	RISS
Date of Demolition:	09/29/03
Additional Information:	Attached

(Must include information on environmental releases and conditions of site at turnover to Environmental Restoration)

Section B. Final Characterization Data

Reconnaissance Level Characterization Report	10/09/03
<i>(concurrency received)</i>	
In-process Characterization	N/A
Pre-Demolition Survey Report <i>(approval received)</i>	RLC functioned as PDS
Post-Demolition Survey Report <i>(as necessary)</i>	N/A

Section C. Waste Data *(complete categories as appropriate)*

Sanitary Disposal

Disposal Site:	Front Range Landfill, Erie, CO.
Waste Volume (m ³):	300
Waste Weight (tons):	217
Additional Information:	Waste included building structure, pad and foundation.

Hazardous Disposal

Disposal Site:	Kettleman Hills Facility, Kettleman City, CA or Bethlehem Apparatus Co., Hellertown, PA.
Waste Volume (m ³):	Less than 1m ³
Additional Information:	Circuit boards, fluorescent lamps, Hg switches, etc. were moved to a RFCA Temporary Unit and combined with like waste streams for disposal.

TSCA Waste Disposal (other than ACM)

Disposal Site:	BFI Landfill 88 th /Tower Road, Commerce City, CO
Waste Volume (m ³):	< 1m ³
Additional Information:	PCB ballasts were sent to the landfill as PCB Bulk Product Waste commingled with building debris.

Asbestos Waste Disposal

Disposal Site:	BFI Landfill 88 th /Tower Road, Commerce City, CO
Waste Volume (m ³):	2
Additional Information:	Abatement approval issued on 09/02/03

Low-Level Waste Disposal

Additional Information:	N/A
	No LLW was generated

Low-Level Mixed Waste Disposal

Additional Information:	N/A
	No LLMW was generated


Recycled Material

Additional Information:	Approximately 100 lbs
	Lead materials (glass and shielding) were sent to PU&D for recycling

Property Disposition

Receiver Locations <i>(major items only)</i> :	N/A
Additional Information:	Miscellaneous small items suitable for resale were removed by PU&D

Section D. Approvals

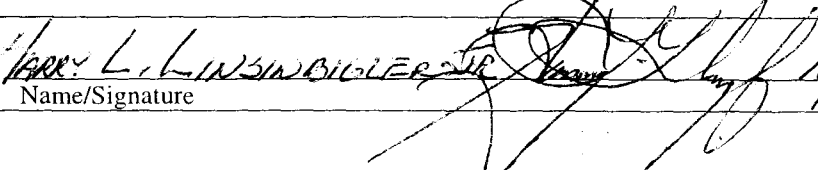Kaiser-Hill Project Manager,		10/24/03 Date
	Name/Signature	

Additional Facility Information


Building 126 was a 450 sf single-story structure built in 1969 that functioned as the Source Calibration Facility. The building was constructed with 12-inch thick concrete walls and a 24-gauge metal and built-up asphalt roof. The floor was a concrete slab poured on grade that had several storage wells used to store radiological sources. The facility was originally used to expose and calibrate radiation detection devices worn by employees. Most recently, the facility was used to package sealed sources for off-site disposal.

Building 126 was serviced by electric and gas, there was never water or sewer service to the building. All utilities were disconnected and capped three feet below grade when Building 125 went offline. The attached map shows approximate utility disconnect locations.

The entire facility, structure and slab, was removed during D&D activities. There are no UBC concerns, and no further work remains other than establishing the final site grade.

Electric Disconnect

Gas Disconnect

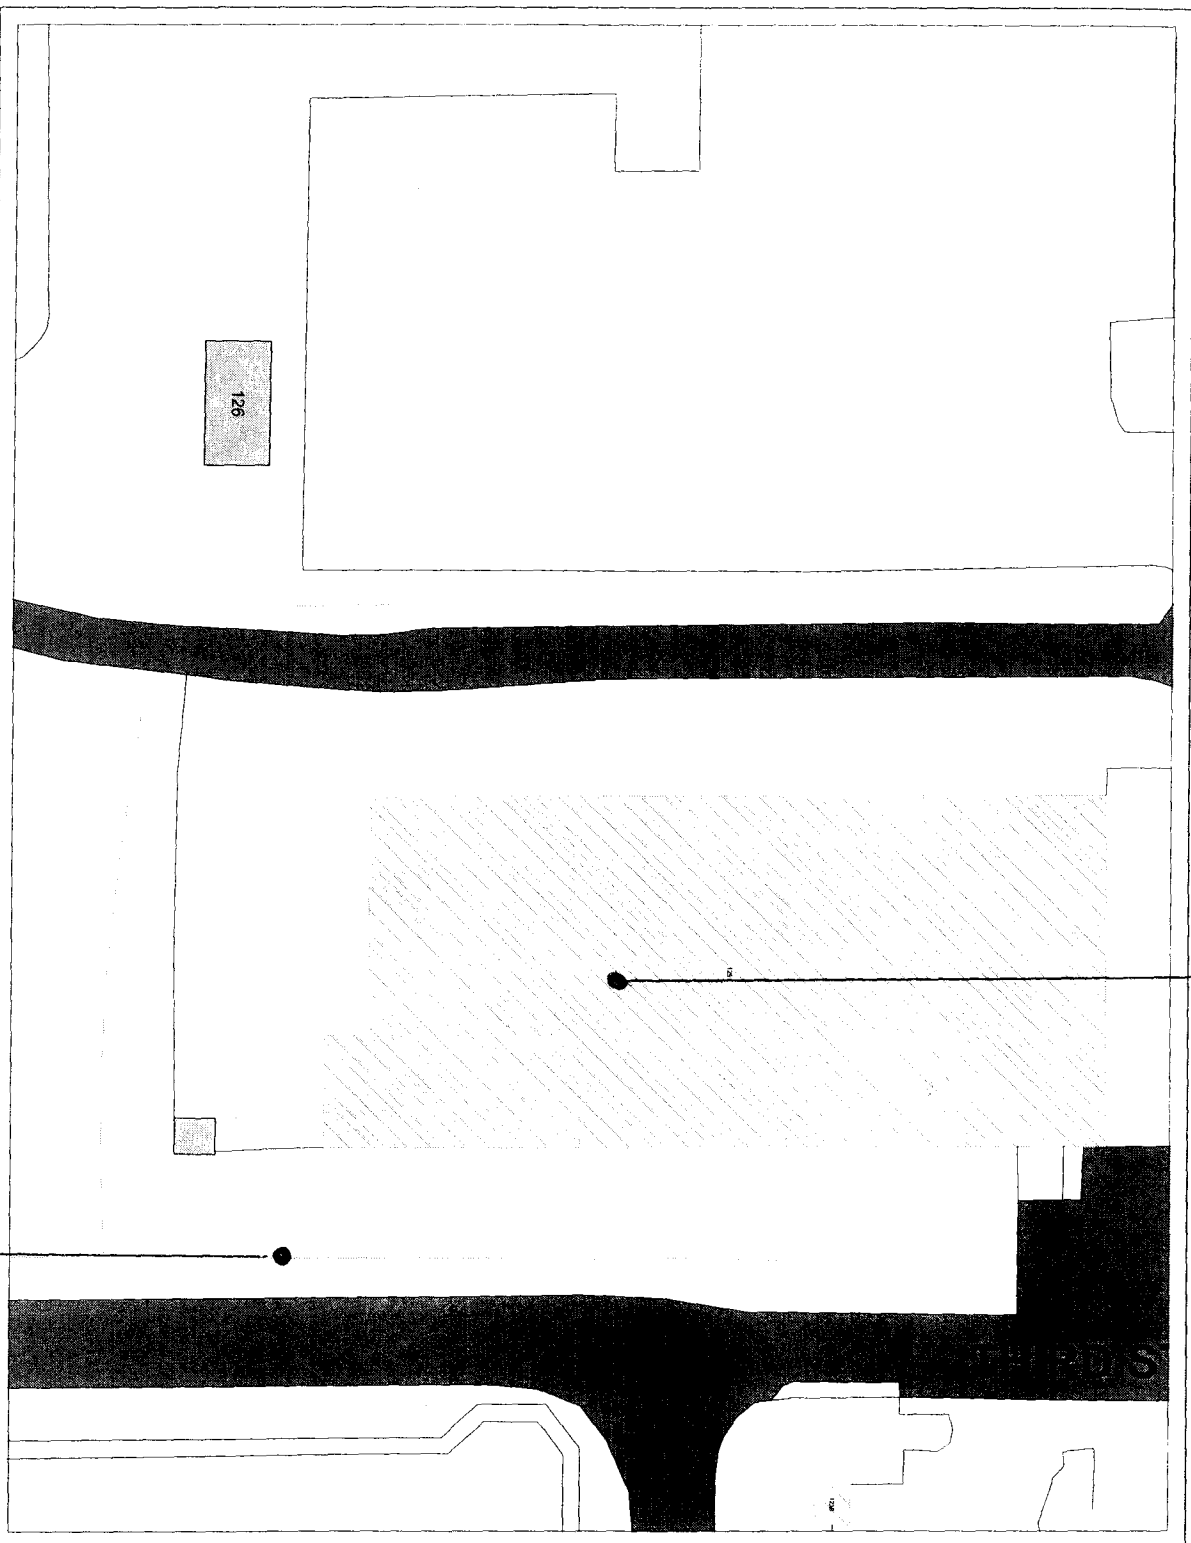

Rocky Flats Environmental Technology Site

Building 126 Utility Disconnect Location

Explanation

- Demolished Buildings
- Lakes
- Streams
- Impermeable Surfaces
- Paved Roads Outline
- Dirt Roads
- Trails
- Railroads
- 25 Foot Contours
- Solar Evaporation Ponds
- fence 1/4 arc
- Buildings

Neither the United States Government nor Kaiser
 Hill Co., nor CH2M-Hill, nor any agency thereof,
 makes any warranty, expressed or implied, or
 assumes any legal liability for the accuracy,
 completeness, or usefulness of any information,
 product, or process disclosed or represents that
 its use would not infringe privately owned rights.



1:385
 1 inch equals 30 feet
 State Plane Coordinate Projection
 Colorado Central Zone (3476)
 Datum: NAD27

Prepared by:

CH2M-HILL

Kaiser Hill
 COMPANY

MAP ID:

August 18, 2003